



# Apt. 2

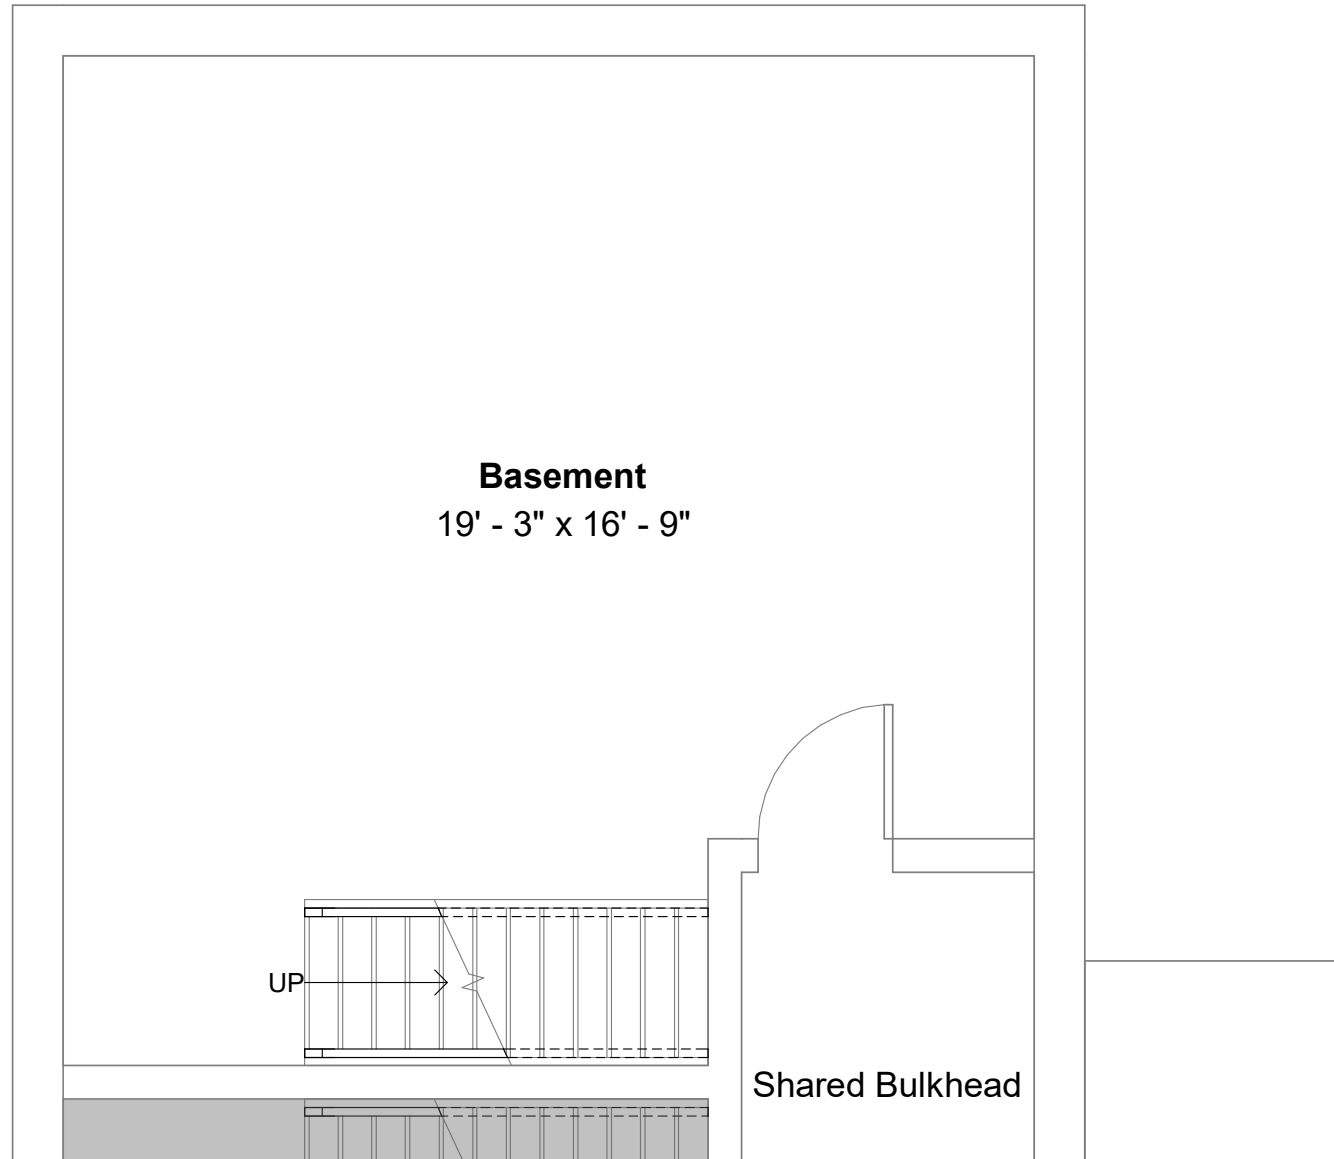

BASEMENT  
NOT TO SCALE



**4 VALLEY ROAD - APT. 2**  
920 SQ. FT. COLONIAL REVIVAL

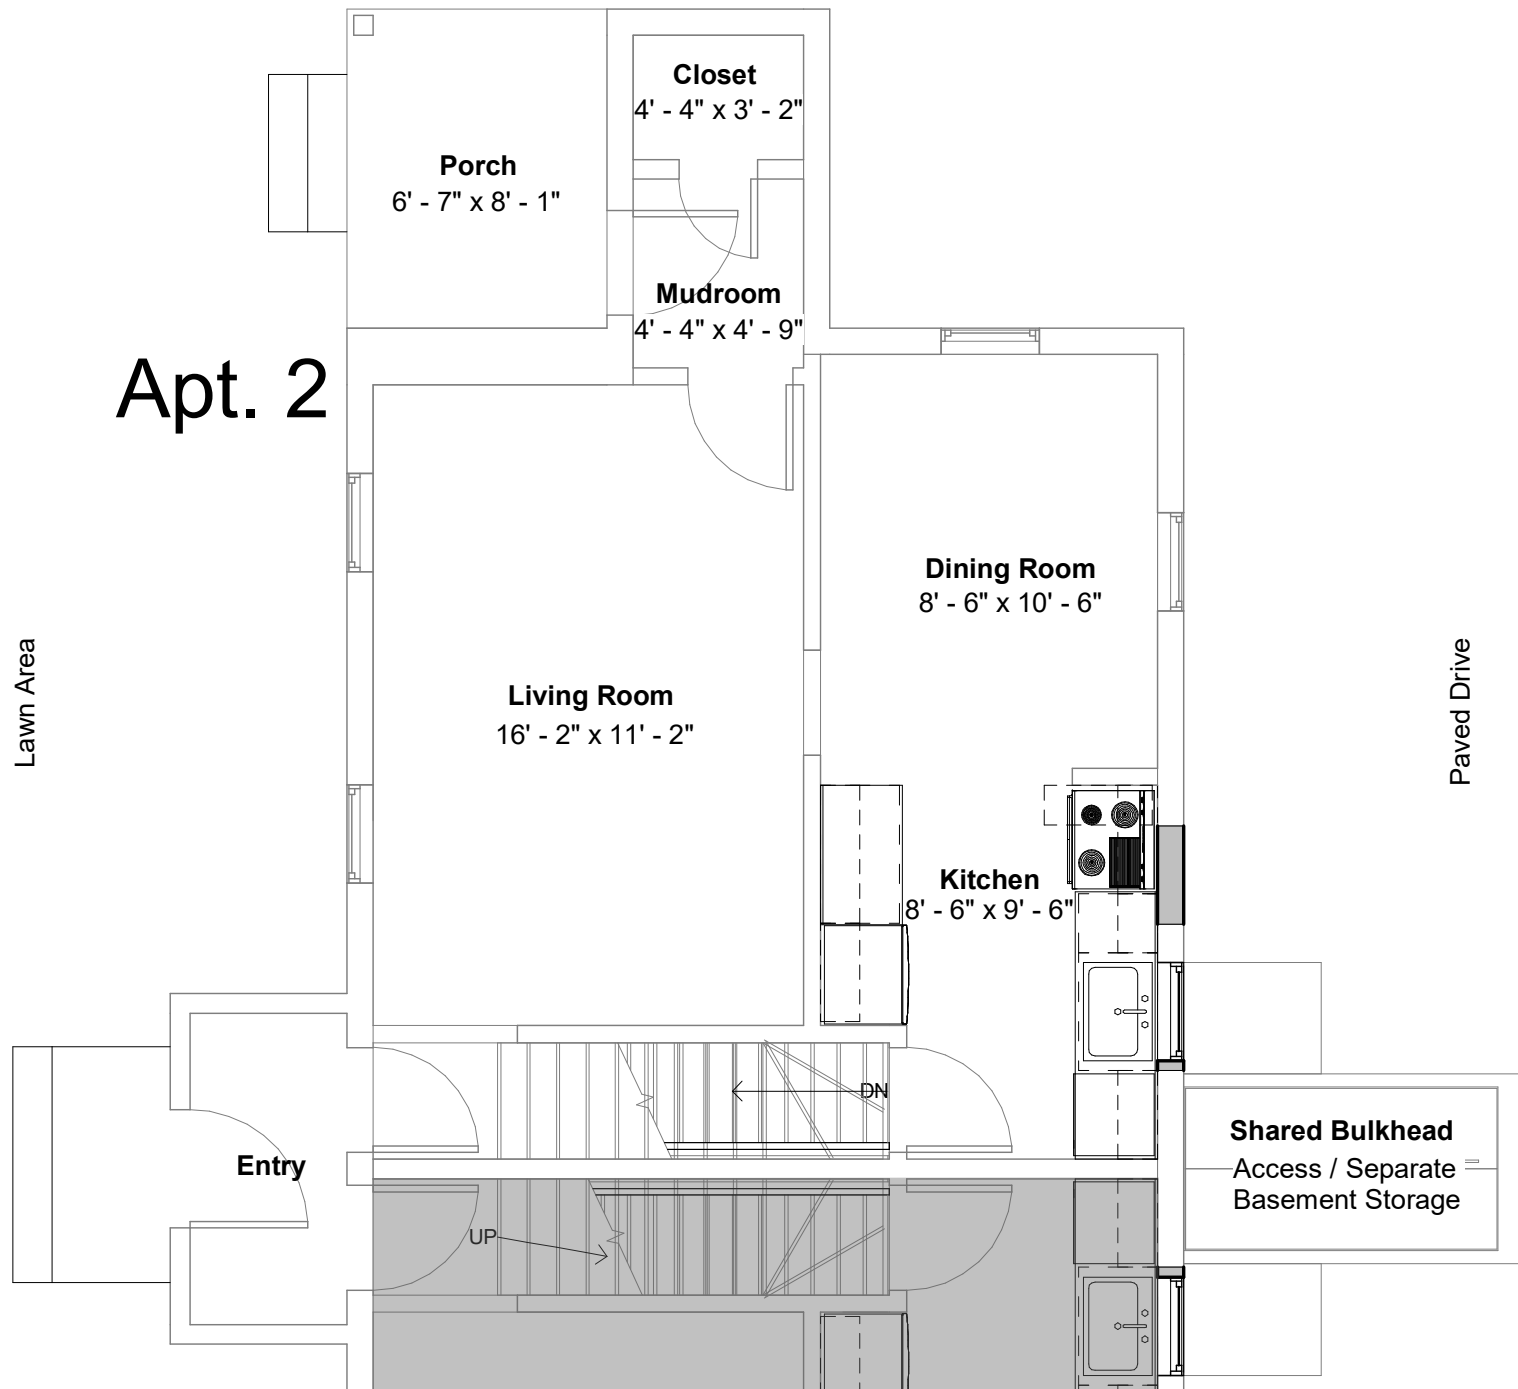


FIRST FLOOR  
NOT TO SCALE



**4 VALLEY ROAD - APT. 2**  
920 SQ. FT. COLONIAL REVIVAL

# Apt. 2

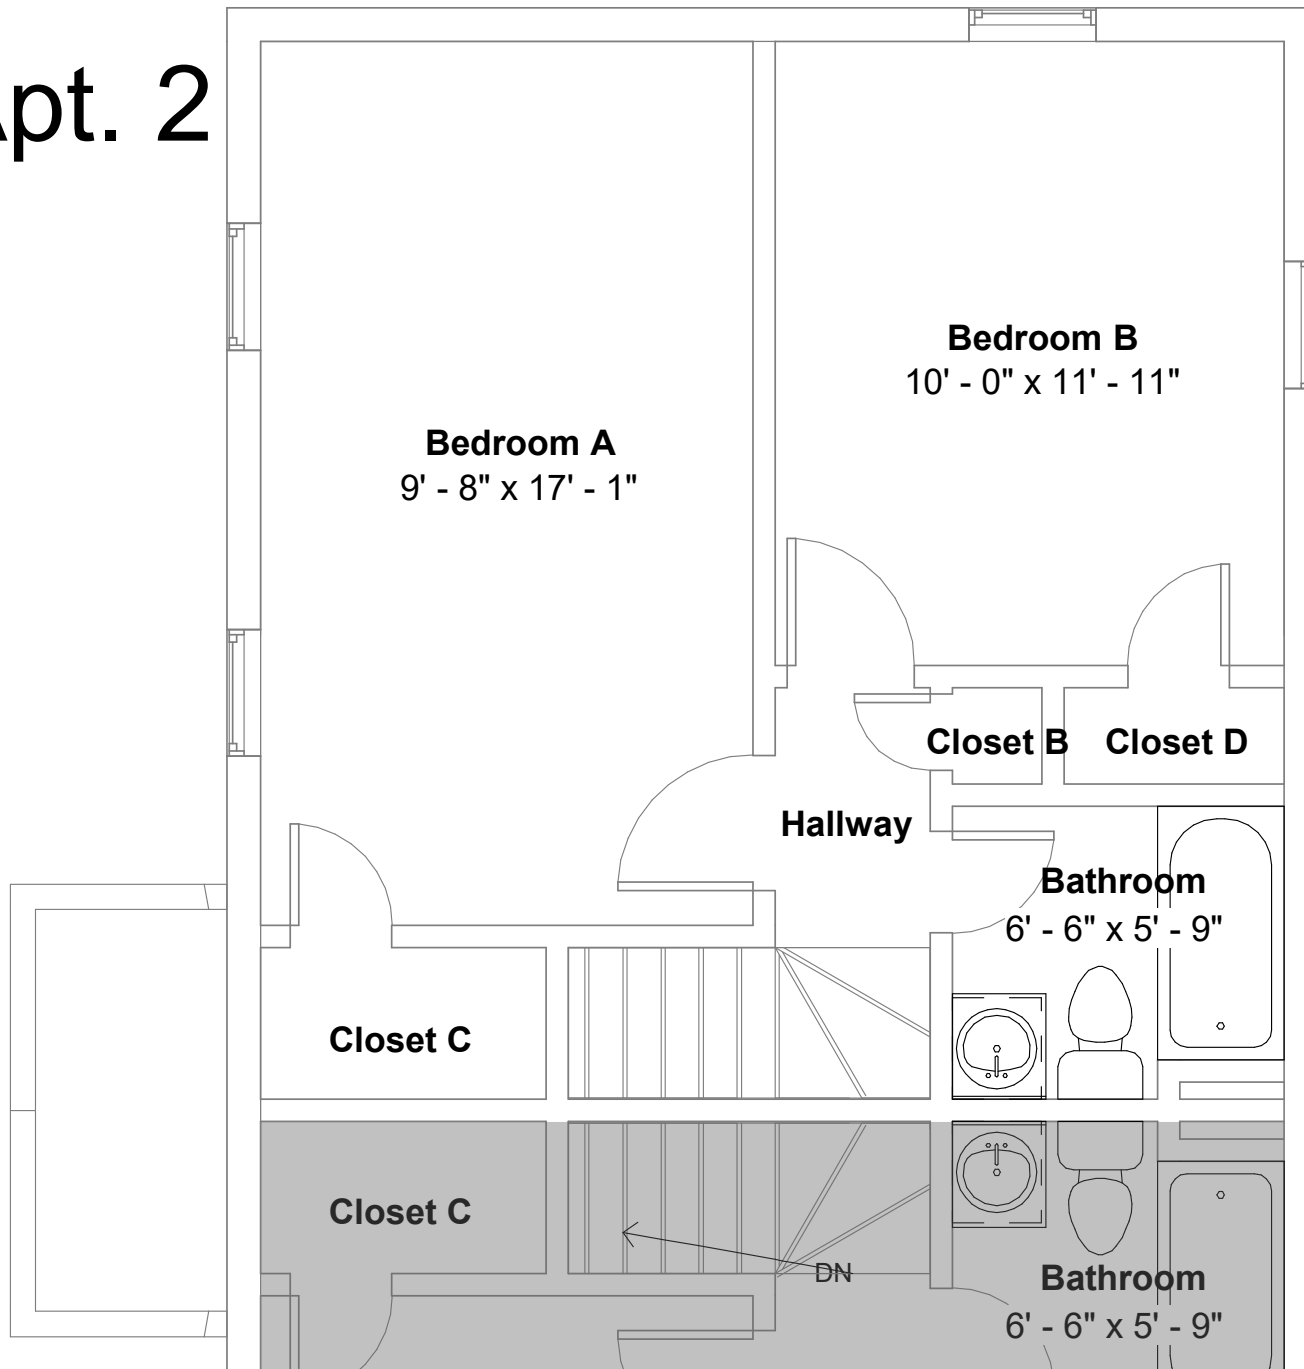


SECOND FLOOR  
NOT TO SCALE



4 VALLEY ROAD - APT. 2  
920 SQ. FT. COLONIAL REVIVAL


Apt. 1

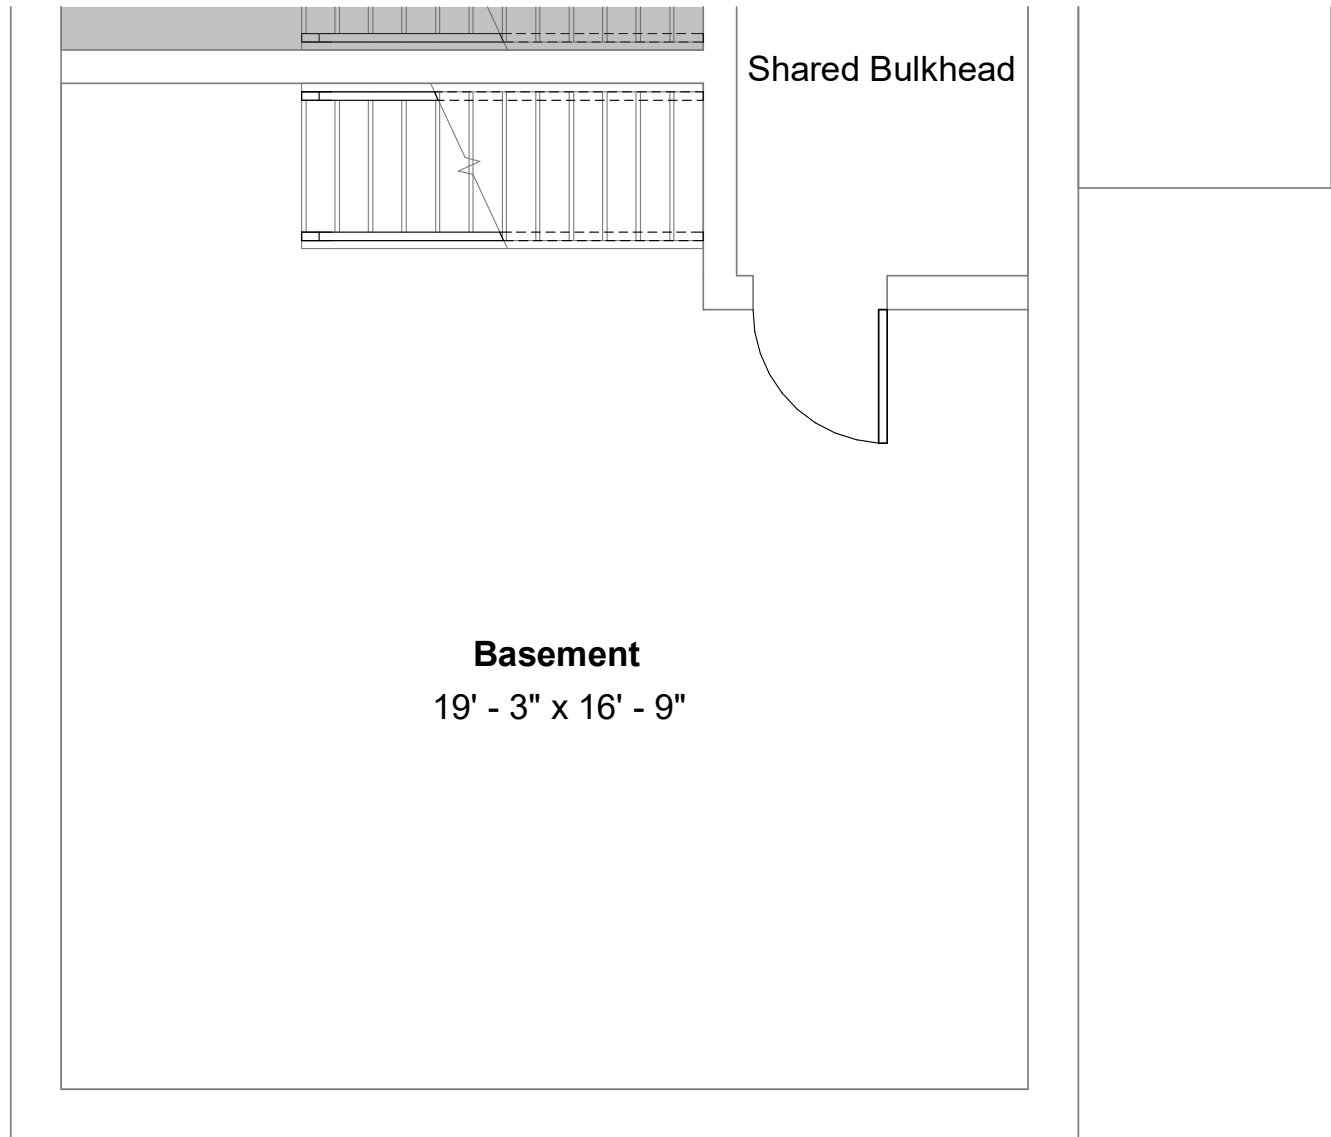

BASEMENT  
NOT TO SCALE



4 VALLEY ROAD - APT. 1  
920 SQ. FT. COLONIAL REVIVAL

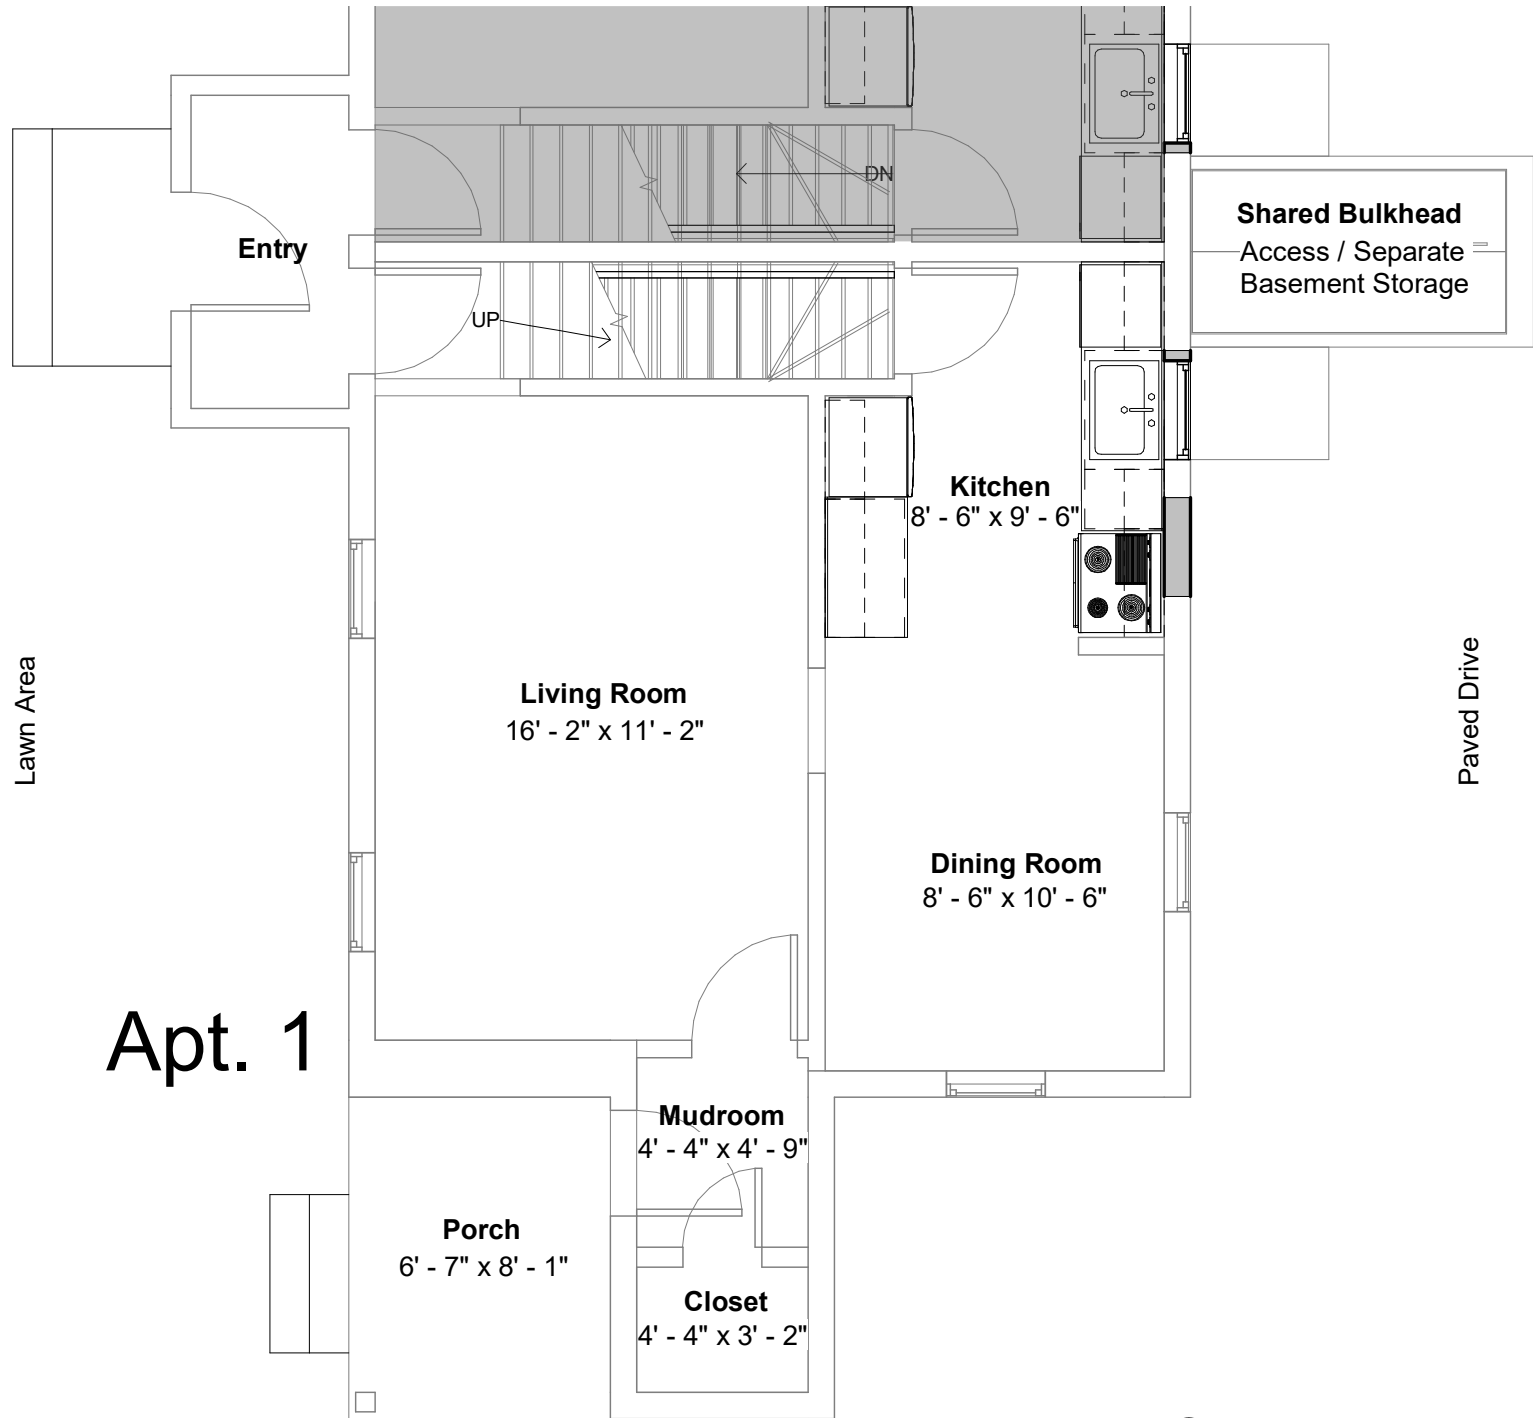


**Apt. 1**

FIRST FLOOR  
NOT TO SCALE



**4 VALLEY ROAD - APT. 1**  
920 SQ. FT. COLONIAL REVIVAL

# Apt. 1

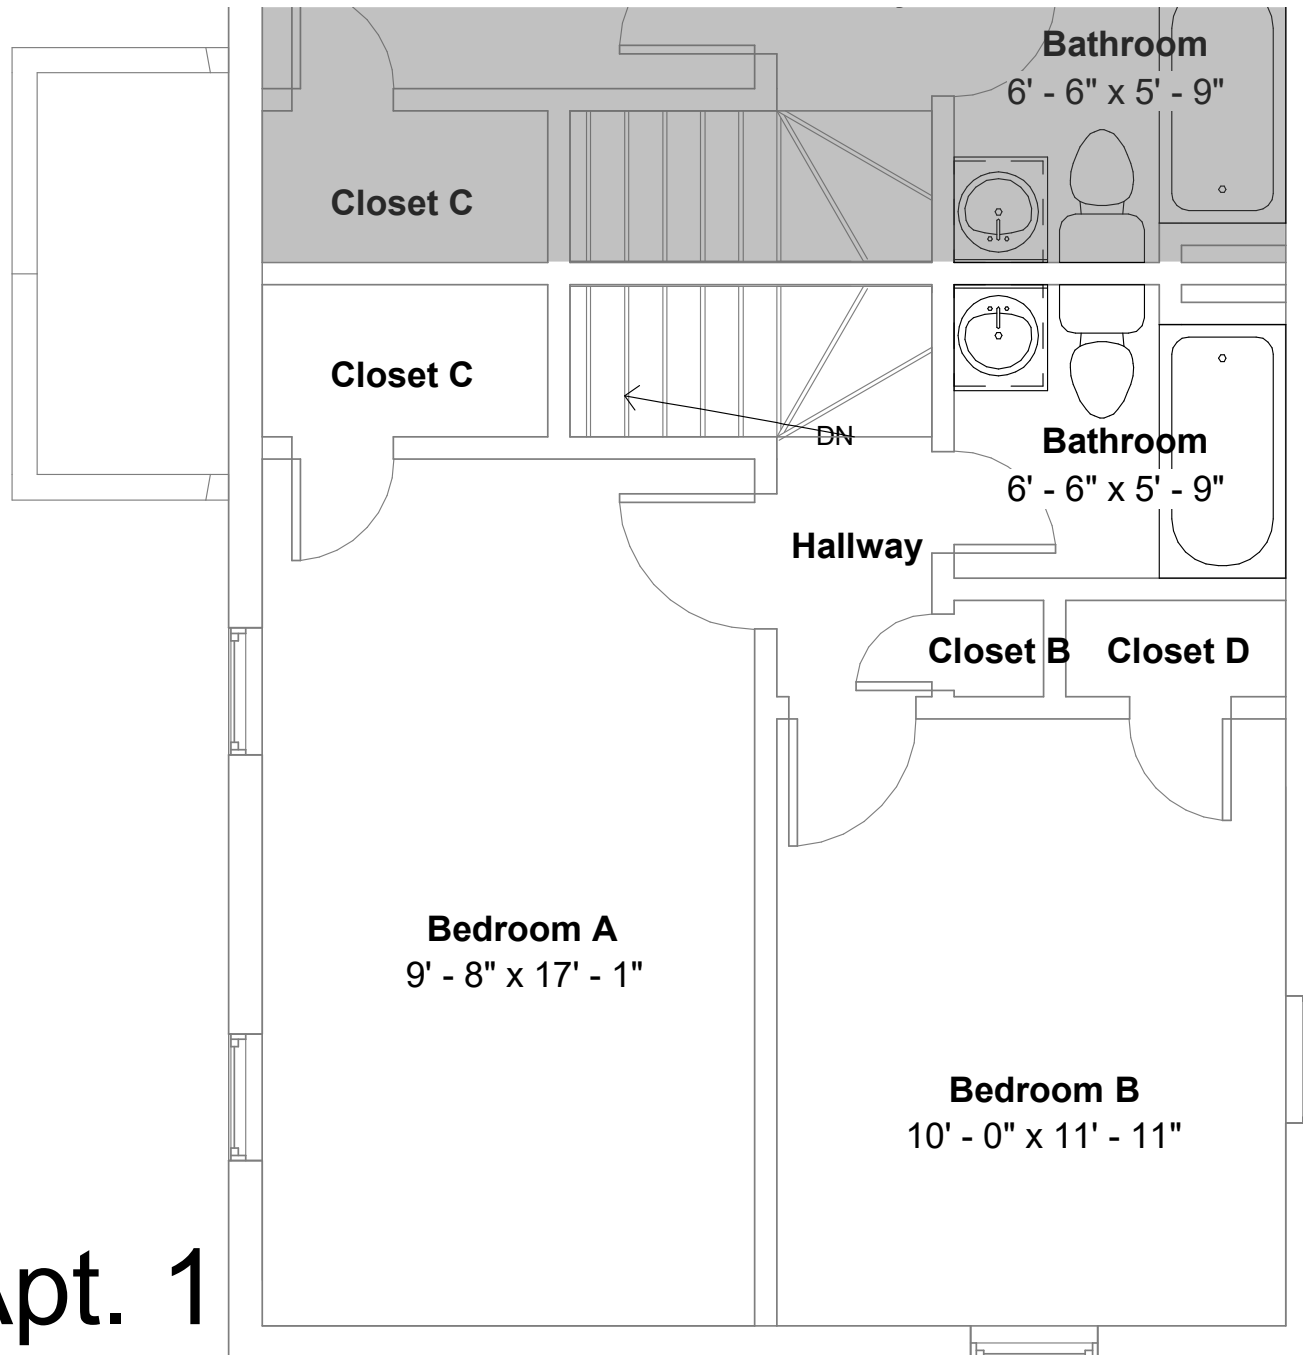

SECOND FLOOR  
NOT TO SCALE



4 VALLEY ROAD - APT. 1  
920 SQ. FT. COLONIAL REVIVAL